


N4W1



Cody St.

7-1

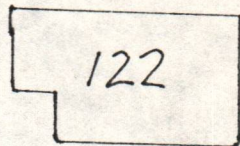


JACKSON AVE.



120'

18.0'

137A1B1

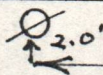

2.0'

37.0'



2 1/4" C.C.