



N4W1



8-2

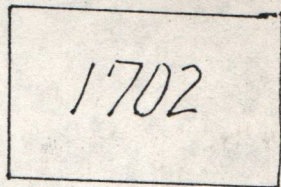

JACKSON AVE.

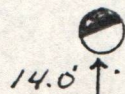

14.0'

18.0'

2.8'

4.0'

137A183

CARSON St.

2" C.I.