


N4W2

20-1



DREW STREET

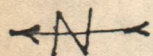