


6-1

N

N4W2

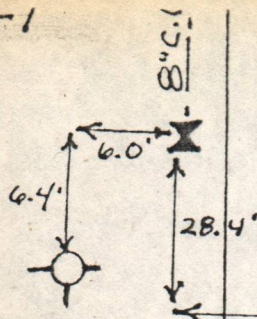

33.8'

Ø 137A200

124.

BOONE STREET

JACKSON AVENUE