


N4W2


SEWER PLANT

6-2

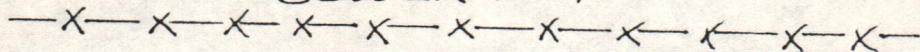

BOONE

STREET

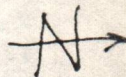

6.4'

16.8

2 1/4" C.I.

3.9'

35.4'

T.P.
NO #

JACKSON AVE.

