




63

SEWER PLANT

N4W2

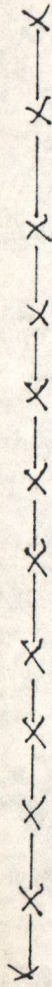

BOONE St.

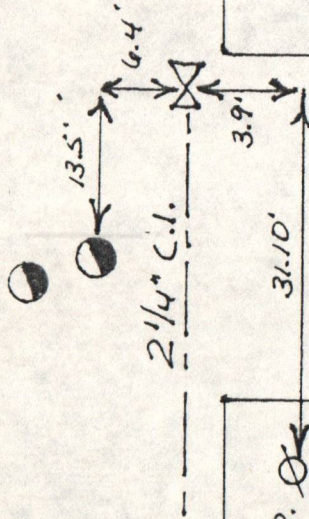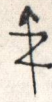

T.P. NO. #

31.10'

JACKSON

