



N4W2

SEWER PLANT

6-4

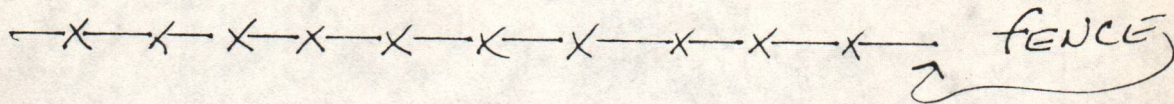

BOONE St.

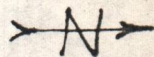

JACKSON AVE.

