


10-1



2" C.I.

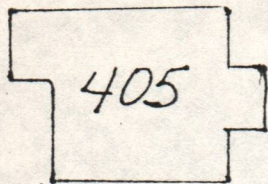

29.0'

SD

16.3'

13.5'



Ninth St.

N4W3

↑
TO 4TH AVE

1.0'
137A21B

ALLEY

↓
TO 5TH AVE