


N4W3

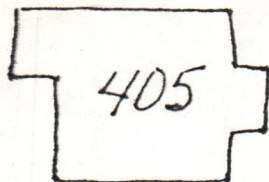

10-2

↑
TO
4th AVE.

Ø 137A218

2'1/4" C.I.

27.0'

2.0'

13.8'

11.7'

ALLEY

Ninth St.

TO
5th AVE.

