


23-1

N4W3

← 70 5th AVE.


70 6th AVE →

ALLEY

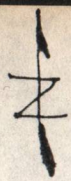

Tenth

Street

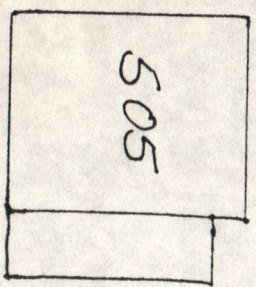

GARAGE
TO
922
SIXTH
AVE.

