


N4W5

← 5TH AVE



Tenth STREET

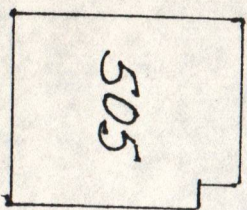


ALLEY



18.9'

6TH AVE →

23-2

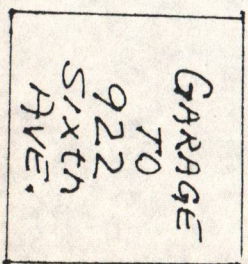

16.8'

6.0'

14.5'

4" C.I.