



24-1

N4W3

Park St.

Fifth Avenue

LINCOLN

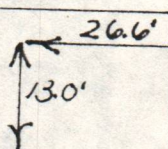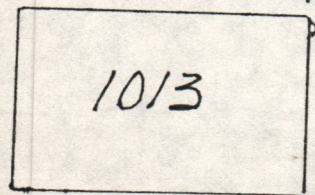

6" C.I.

