


11-32

N4W4

521



6" C.I.

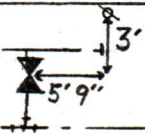

2" C.I.

2" PVC

551

6" PVC

ONE VALLEY BANK

GAS
Station