


N4W4

McCLUNG
& MORGAN

13-2

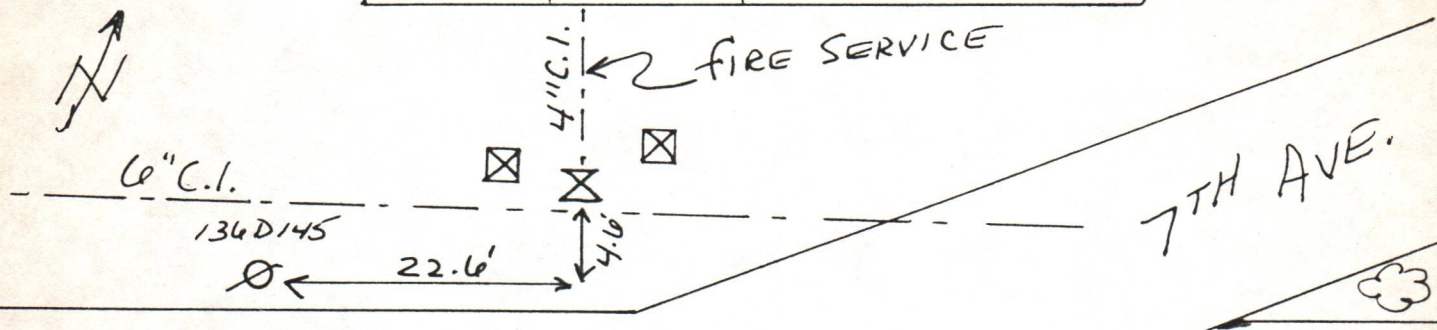

KANAWHA TERRACE

309