


14-1

N4W4

4th St.

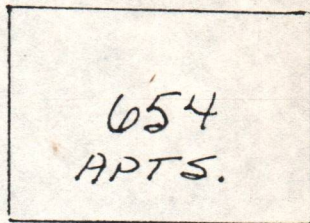

SEVENTH

AVENUE

RAMP

RAMP

