


N4W4

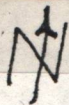

14-4

KANAWHA TER.

4TH STREET
(UNPAVED)
5' 27.86

