

N4W4


N

15-1

KANAWHA

TERRACE

3RD STREET

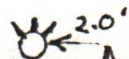

49.0'

12" C.I.

10.0' 2.0'

utility
light pole