

17-1

517

523

SIXTH ST.

6TH AVE.


N4W4

607

2" C. I.

ALLEY

2" C. I.

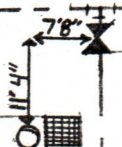

2" PVC

653

651-
A-B-C-
& D

518

650

VILLAGER APT'S.