


5-1

N4W4N

AVENUE

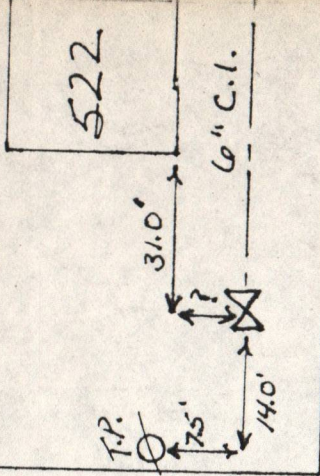

Sixth Street

Z

Fifth

N