


N4W4

8-2



6" C.I.

SIXTH AVENUE

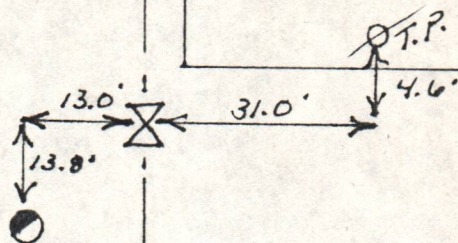

4th St.

LIBRARY