


N4W5

11-1

2ND AVE

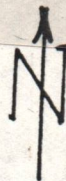

OLDE MAIN PLAZA

8" D.I.

11'8"

14.0'

8" C.I.

MAIN ST.

PENNSYLVANIA

95

