


N4W5

21-1

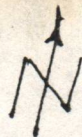

B¹ ST.

8th

AVENUE

