



3-2

PARKING
LOT

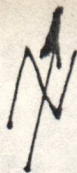

POLICE
DEPT.

N4W5

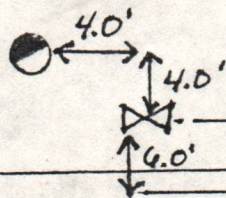

2" C.I.

ALLEY

519
LOOP

50
OLDE
MAIN
PLAZA