


5-2

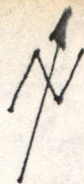

N4W5

SIXTH AVENUE

"C" STREET

2.0' T.P.

54.10'

26.7'

9.10'

3" P.V.C.

101

103

PROFESSIONAL
BUILDINGS