


N4WS

519
LOOP



50
OLDE
MAIN
PLAZA

9-2

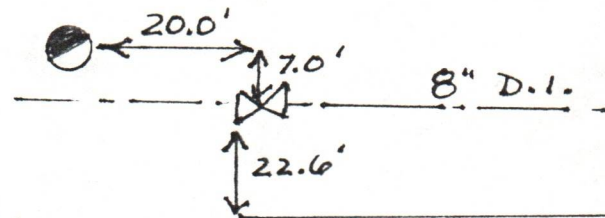

PLAZA

PARKING
AREA

"B" STREET
(WALKWAY)

51
OLDE
MAIN
PLAZA