

9-3




519
LOOP

"B" STREET
(WALKWAY)

N4W5

50
OLDE
MAIN
PLAZA

PLAZA

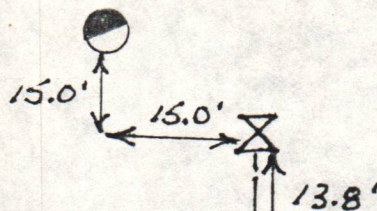

8" C.I.

51
OLDE
MAIN
PLAZA
(MUSIC CO.)