


9-5

SIDEWALK

PARKING  
LOT

"B" STREET

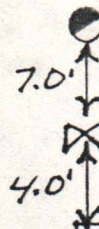

7.0'

4.0'



T.P.

14.3'

9.0'

ALLEY

2 1/4" C.I.

806  
HEALTH CLUB

N4W5