
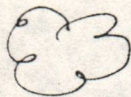


24-1

N5°W2

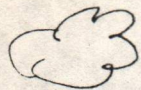

MAC CORKLE

AVENUE

(U.S. 60)

