


10-1

LONG
JOHN
SILVERS



N5W4

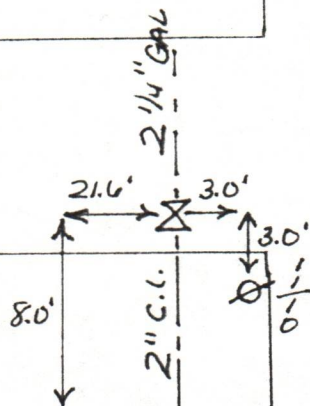

GARAGE

4th
Street

ALLEY

402