


N5W/4

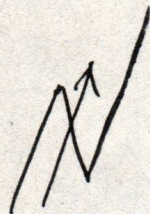

Mac CORKLE AVE

5th STREET

11-1

137A126

27'

8" C. I.

HARDEES

2" C. I.

2" C. I.