


4-1

C & D
CAR
LOT



N5W4

402

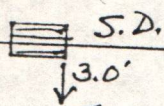

MACCORKLE

LONG
JOHN
SILVERS

2 1/4" C.I.

4th STREET

AVENUE