


N5W4

5-1

500
PIZZA
HUT

SERVICE
STATION

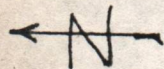

5th

MAC CORKLE AVE.

STREET

