



N5W5

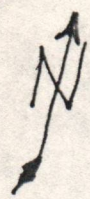

"C" STREET

6" C.L.

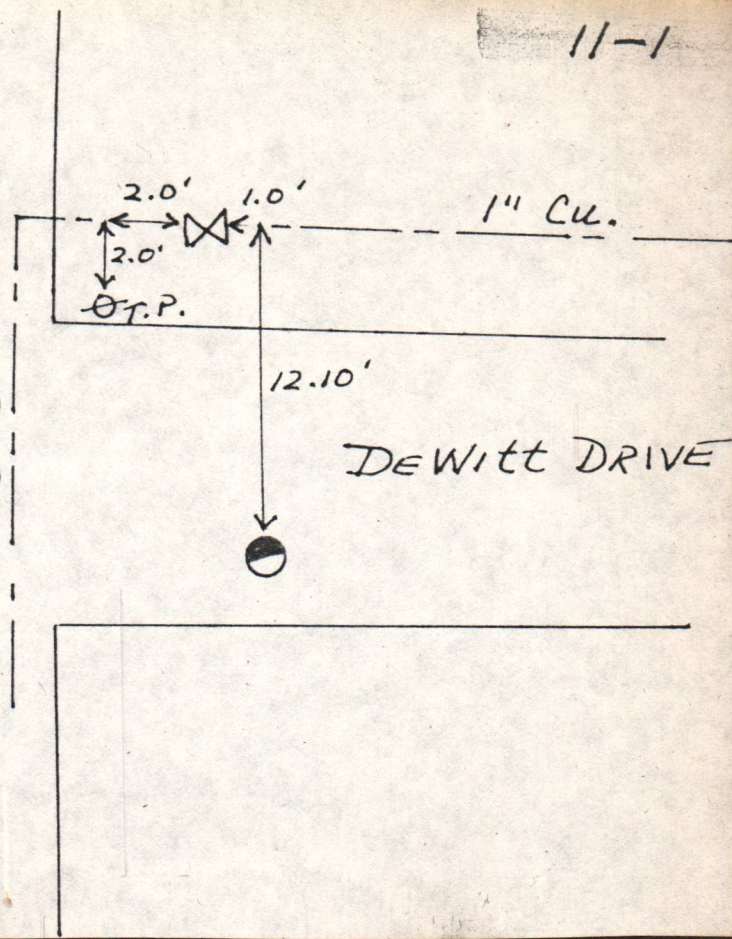

11-1

DEWITT DRIVE