


N5W5

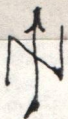

STREET

12-3

4th AVENUE

2ND

