



21-1

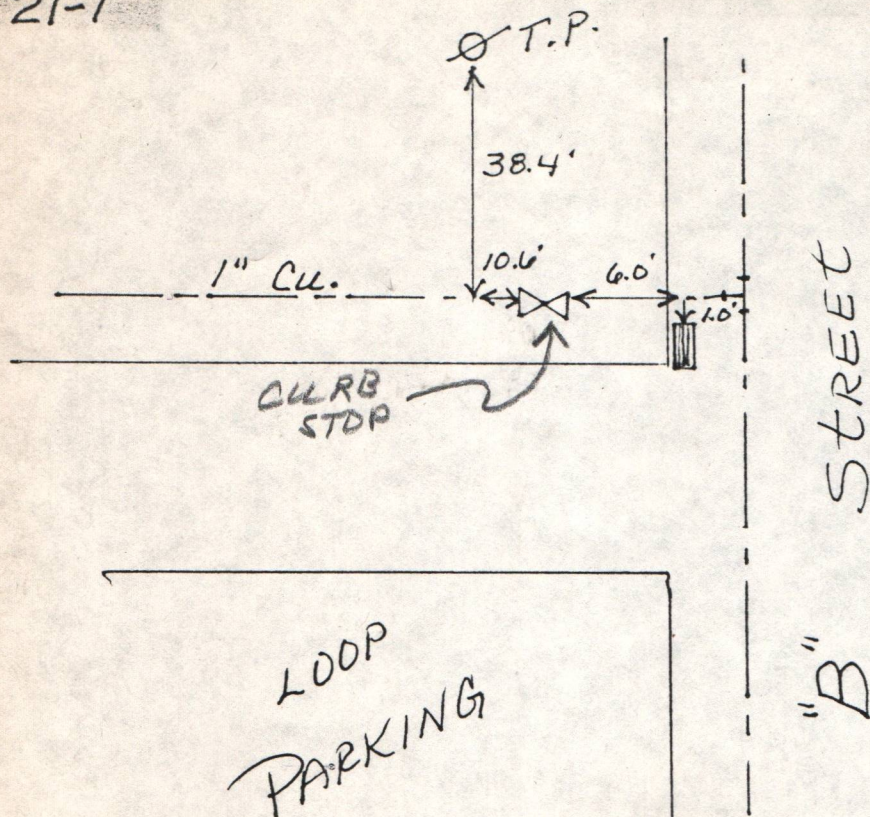

N5W5

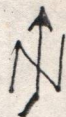

6th AVENUE

"B" STREET

FIRE &
POLICE
DEPT.