


3-1



"B" STREET

N5W5

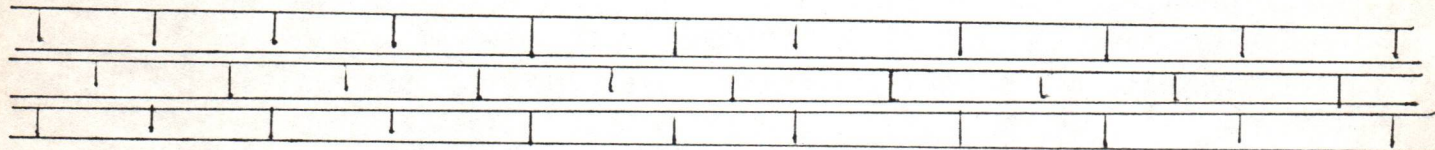

4TH

AVENUE

$\frac{x}{14}$

CURB
STOP

1" GAL ABANDONED

