

21-3


FOOTBALL
FIELD

MAC CORKLE

RAX

3RD ST.

6" C.I.

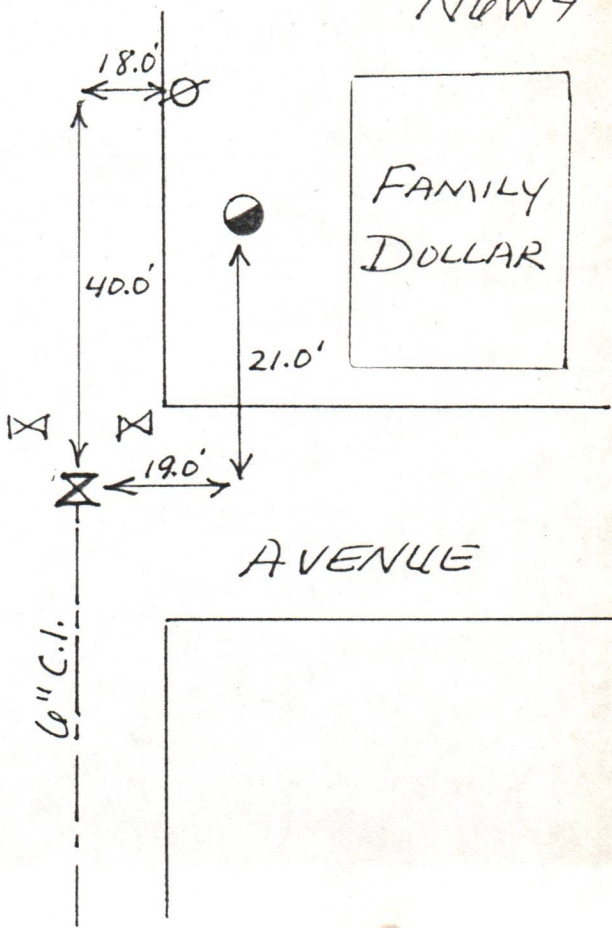

N6W4

FAMILY
DOLLAR

AVENUE