


N6W5

15-1

Route 60

STREET
"B" $\nearrow$

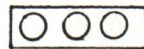

GAS
STATION

6" C.L.

T.P.

24.0'

7.0'

10.0'

2.0'

GATEWAY
PARKING

