

N6W5


17-2

STREET
71
"C"

MAC CORKLE

AVENUE

2" C.I.

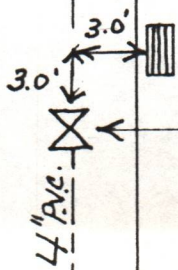

27.0'

Ø T.P.

16.0'