


VS

AVENUE

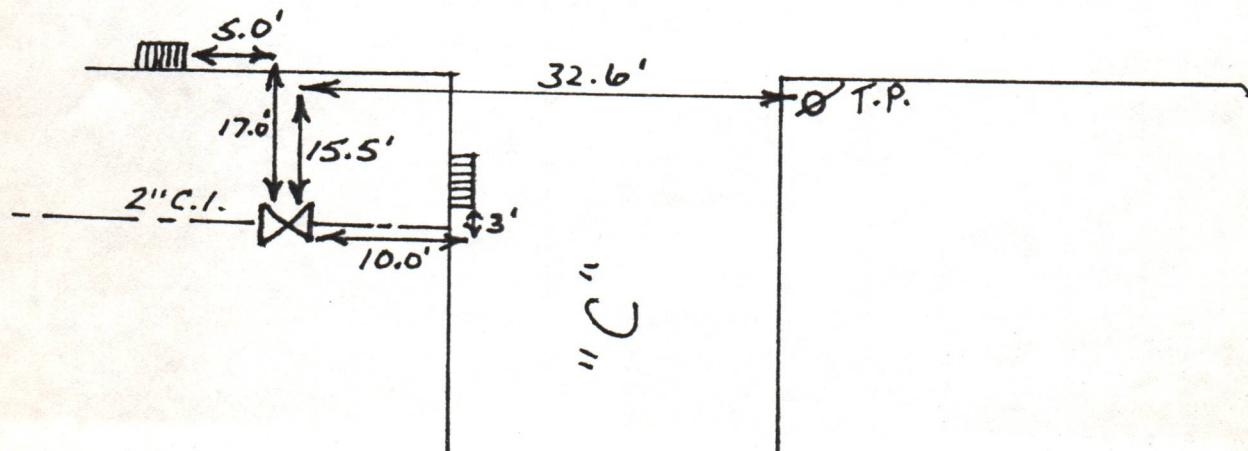

“C”