


NGW5

GATEWAY
SHOPPING
CENTER

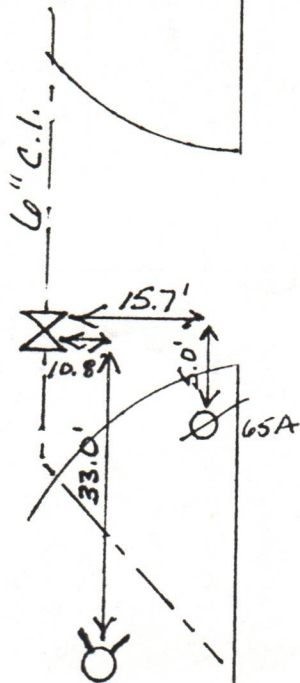

"B"

STREET



LEWIS AVE

21-2