

23-1

N6W5




St.

"C"

LEWIS AVENUE

ALLEY

2" C.I.

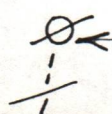


31.0'

4" P.V.C.



30.0'

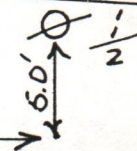

6.0'

1/2