


N6W5

3-1

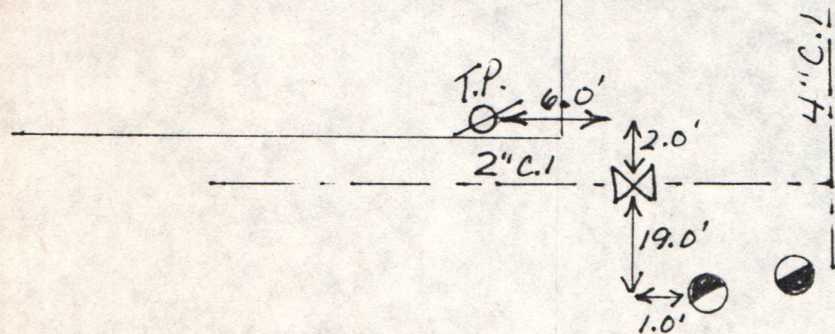

1st AVE

"B" ST.