


4-1

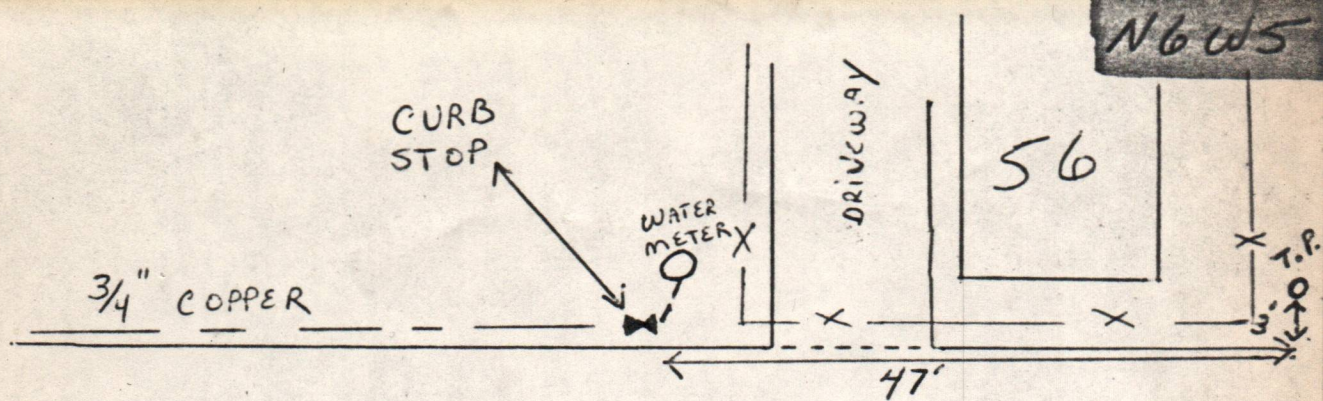

*[Handwritten signature]*