


8-1




"A" STREET

N6W5

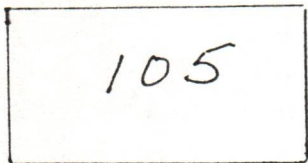

APT.
METERS

6" C.I.

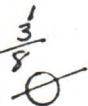

10.0'

2" C.I.

DEAD
END



2.6'

28
MIRIAM

CURB

Route 60