


N6W5



9-3
not shown
on maps
5-28-86

MIRIAM AVE.

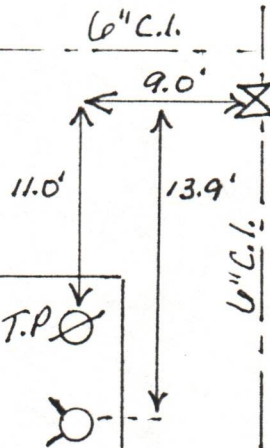

"B" STREET