


13-2

SLOW 7

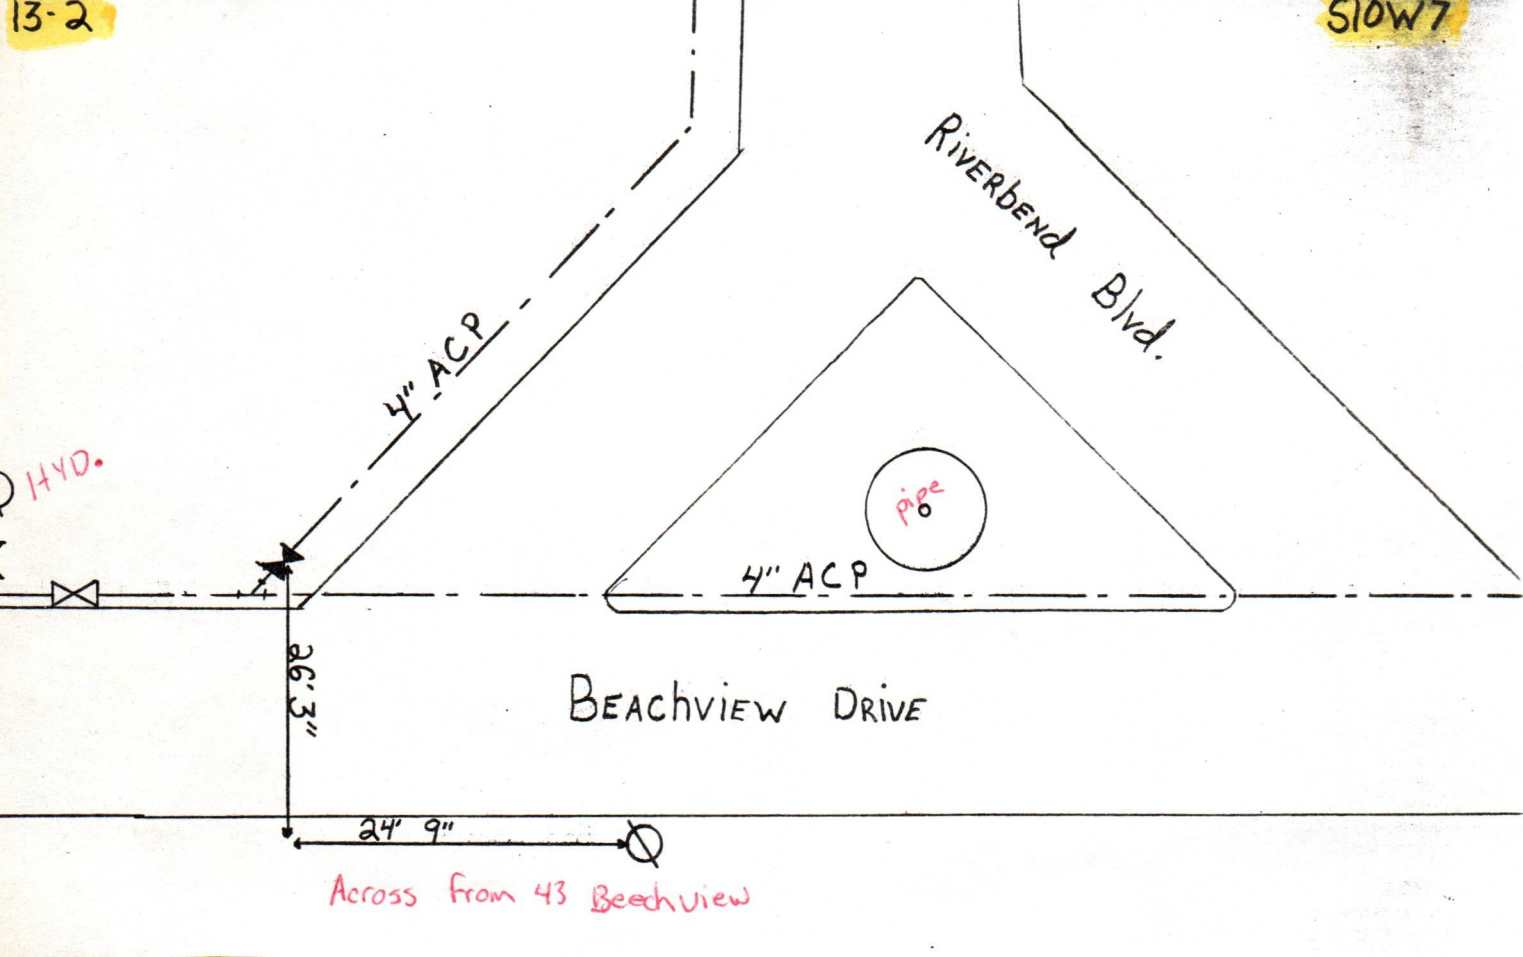

HYD.

RIVERBEND Blvd.

4" ACP

pipe

4" ACP

BEACHVIEW DRIVE

26' 3"

24' 9"

Across from 43 Beechview