


51E1

12-1

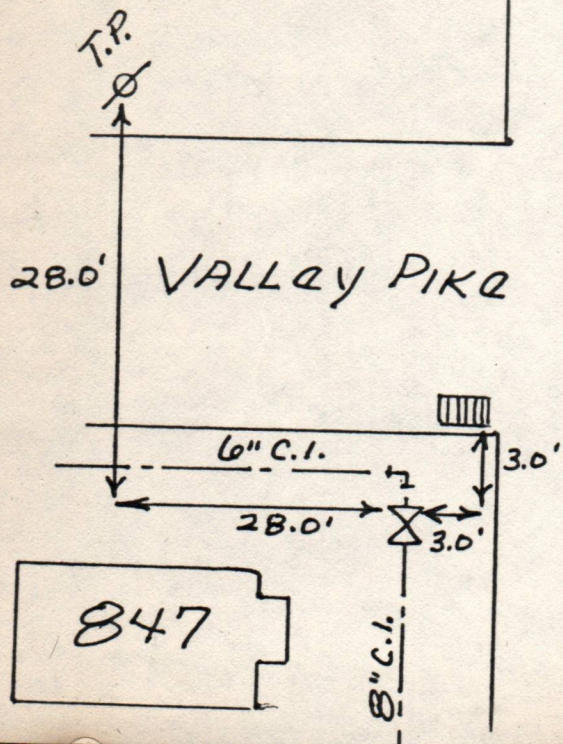

Vine Street

MONMOUTH