


SIE1

12-2

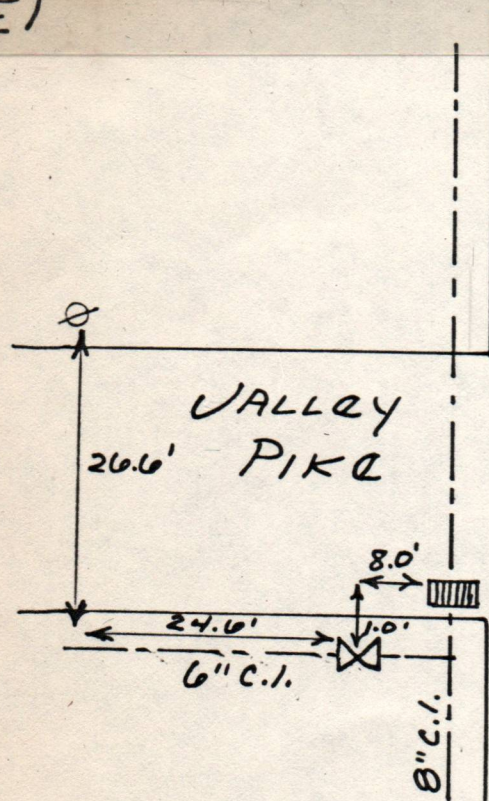

STREET

VINE

MONMOUTH

