


S1E1



STREET

GREENBRIER

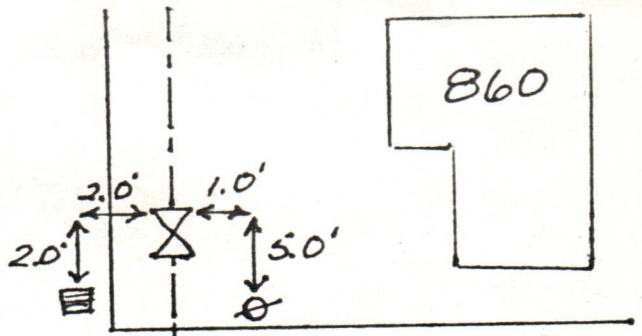

SHORT ST.